

This file is an instrument of service and is to be used solely for the purposes stipulated under separate executed contracts with the Designer. This document is copyrighted and is not to be used, duplicated or otherwise modified except with express permission of the Designer.

Project #

TRUELIGHT MISSIONARY CHURCH

OWNER: TRUELIGHT MISSIONARY BAPTIST CHURCH
4017 HAMILTON ST.
HOUSTON, TEXAS 77004

Issue Date

As Built Drawing Set.
drawn by: William Webb

Revisions

PRELIMINARY
NOT FOR REGULATORY
APPROVAL, PERMITTING,
OR CONSTRUCTION

FIRST FLOOR PLAN
SECOND FLOOR PLAN
Sheet No.

Project #

TRUELIGHT MISSIONARY CHURCH

OWNER: TRULIGHT MISSIONARY BAPTIST CHURCH

4017 HAMILTON ST.
HOUSTON, TEXAS 77004

Issue Date

As Built Drawing Set.
Drawn by: William Webb


Revisions

PRELIMINARY
NOT FOR REGULATORY
APPROVAL, PERMITTING,
OR CONSTRUCTION

SECOND FLOOR PLAN

Sheet No.

A1.1

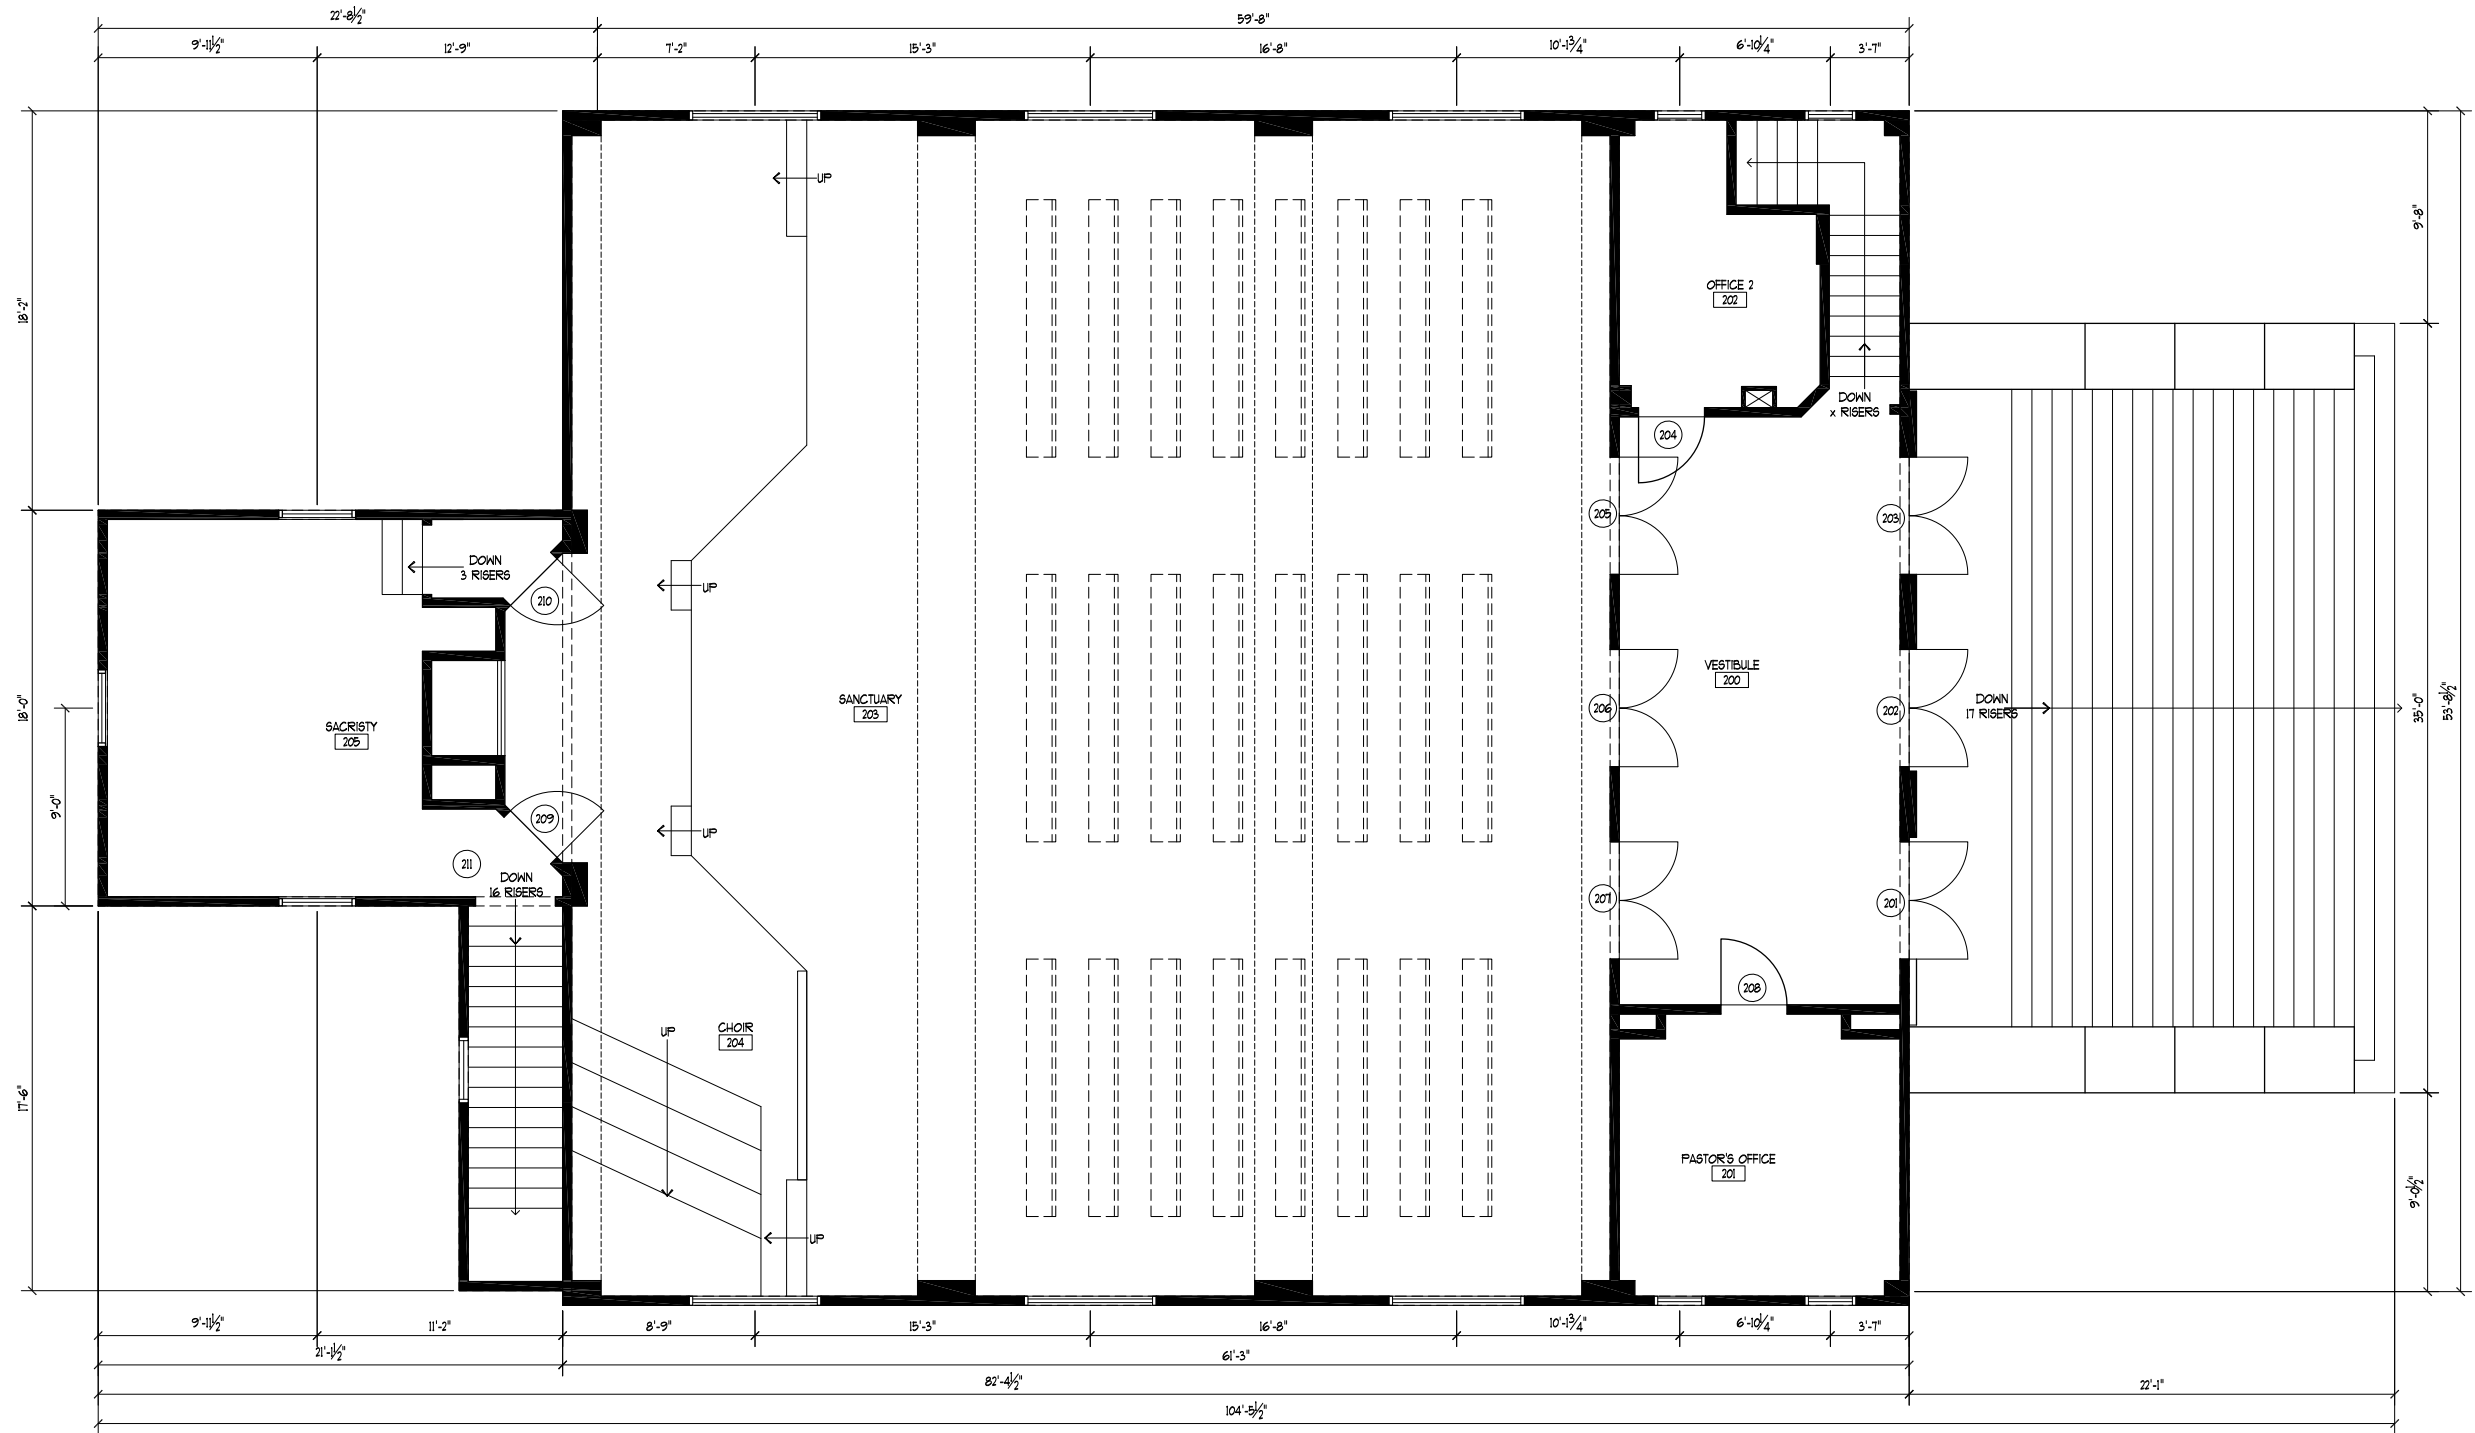



2 FRONT ELEVATION
SCALE 1/8" = 1'-0"



1 RIGHT ELEVATION
SCALE 1/8" = 1'-0"

This file is an instrument of service and is to be used solely for the purposes stipulated under separate executed contracts with the Designer. This document is copyrighted and is not to be used, duplicated or otherwise modified except with express permission of the Designer.

Project #

TRUELIGHT MISSIONARY CHURCH

OWNER: TRUELIGHT MISSIONARY BAPTIST CHURCH
4017 HAMILTON ST.
HOUSTON, TEXAS 77004

Issue Date


As Built Drawing Set.
drawn by: William Webb

Revisions

PRELIMINARY
NOT FOR REGULATORY
APPROVAL, PERMITTING,
OR CONSTRUCTION

FRONT ELEVATION
RIGHT ELEVATION
Sheet No.

A2.1

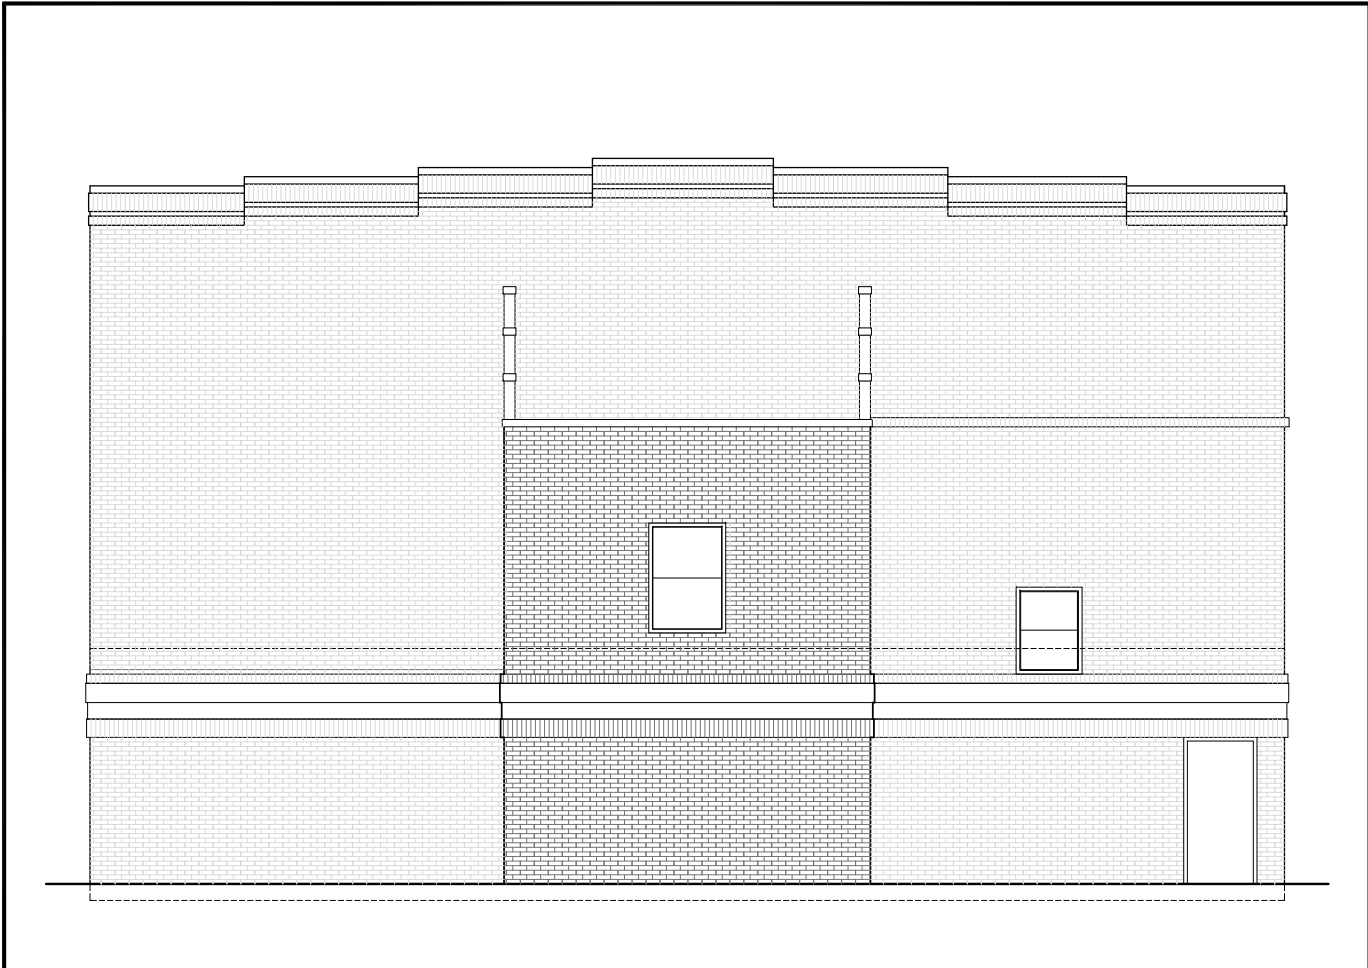

2 REAR ELEVATION
SCALE 1/8" = 1'-0"



1 LEFT ELEVATION
SCALE 1/8" = 1'-0"

This file is an instrument of service and is to be used solely for the purposes stipulated under separate executed contracts with the Designer. This document is copyrighted and is not to be used, duplicated or otherwise modified except with express permission of the Designer.

Project #

TRUELIGHT MISSIONARY CHURCH

OWNER: TRUELIGHT MISSIONARY BAPTIST CHURCH
4017 HAMILTON ST.
HOUSTON, TEXAS 77004

Issue Date

As Built Drawing Set.
drawn by: William Webb

Revisions

PRELIMINARY
NOT FOR REGULATORY
APPROVAL, PERMITTING,
OR CONSTRUCTION

REAR ELEVATION
LEFT ELEVATION
Sheet No.

A2.2