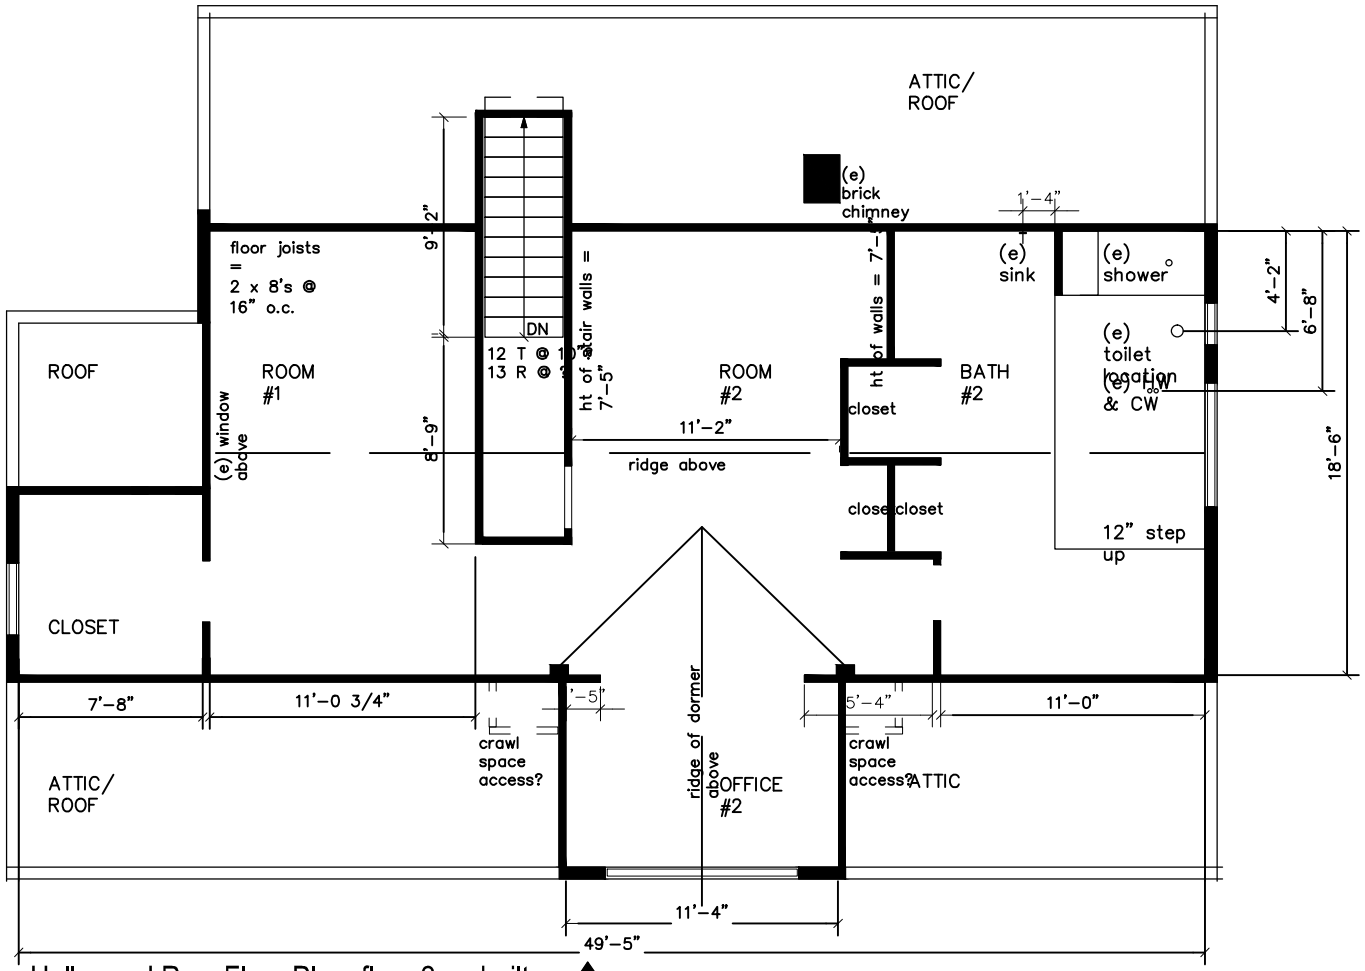

Hollywood Res. Floor Plan: floor 2 as-built

Scale: 1/8" = 1'-0"

N